

→ DIMENSION GO ON THE "DIMENSION" LAYER AND ARE 1-4 MED SIZE

HOLD 1ST STRING OF DIM OFF FROM WALL 2'-0", THEN EVERYONE AFTER THAT 1'-6" SPACING

1-4 SM, NOTES SHOULD BE PLACED IN HORIZ., BUT IF UNABLE, PUT IN VERT. DIRECTION AS SHOWN

ADD WALL HATCH ON THE "HATCH" LAYER - LOOK @ LIBRARY FOR EXAMPLE


TRIM OUT WALL INTERSECTION LINES IF PRESENT, AFTER HATCHING

(TITLE LAYER)
1/4 TITLE SIZE
1-4 MED SIZE
(NOTES LAYER)

ALIGN TEXT TO LEFT

FLOOR PLAN

SCALE: 1/4" = 1'-0"

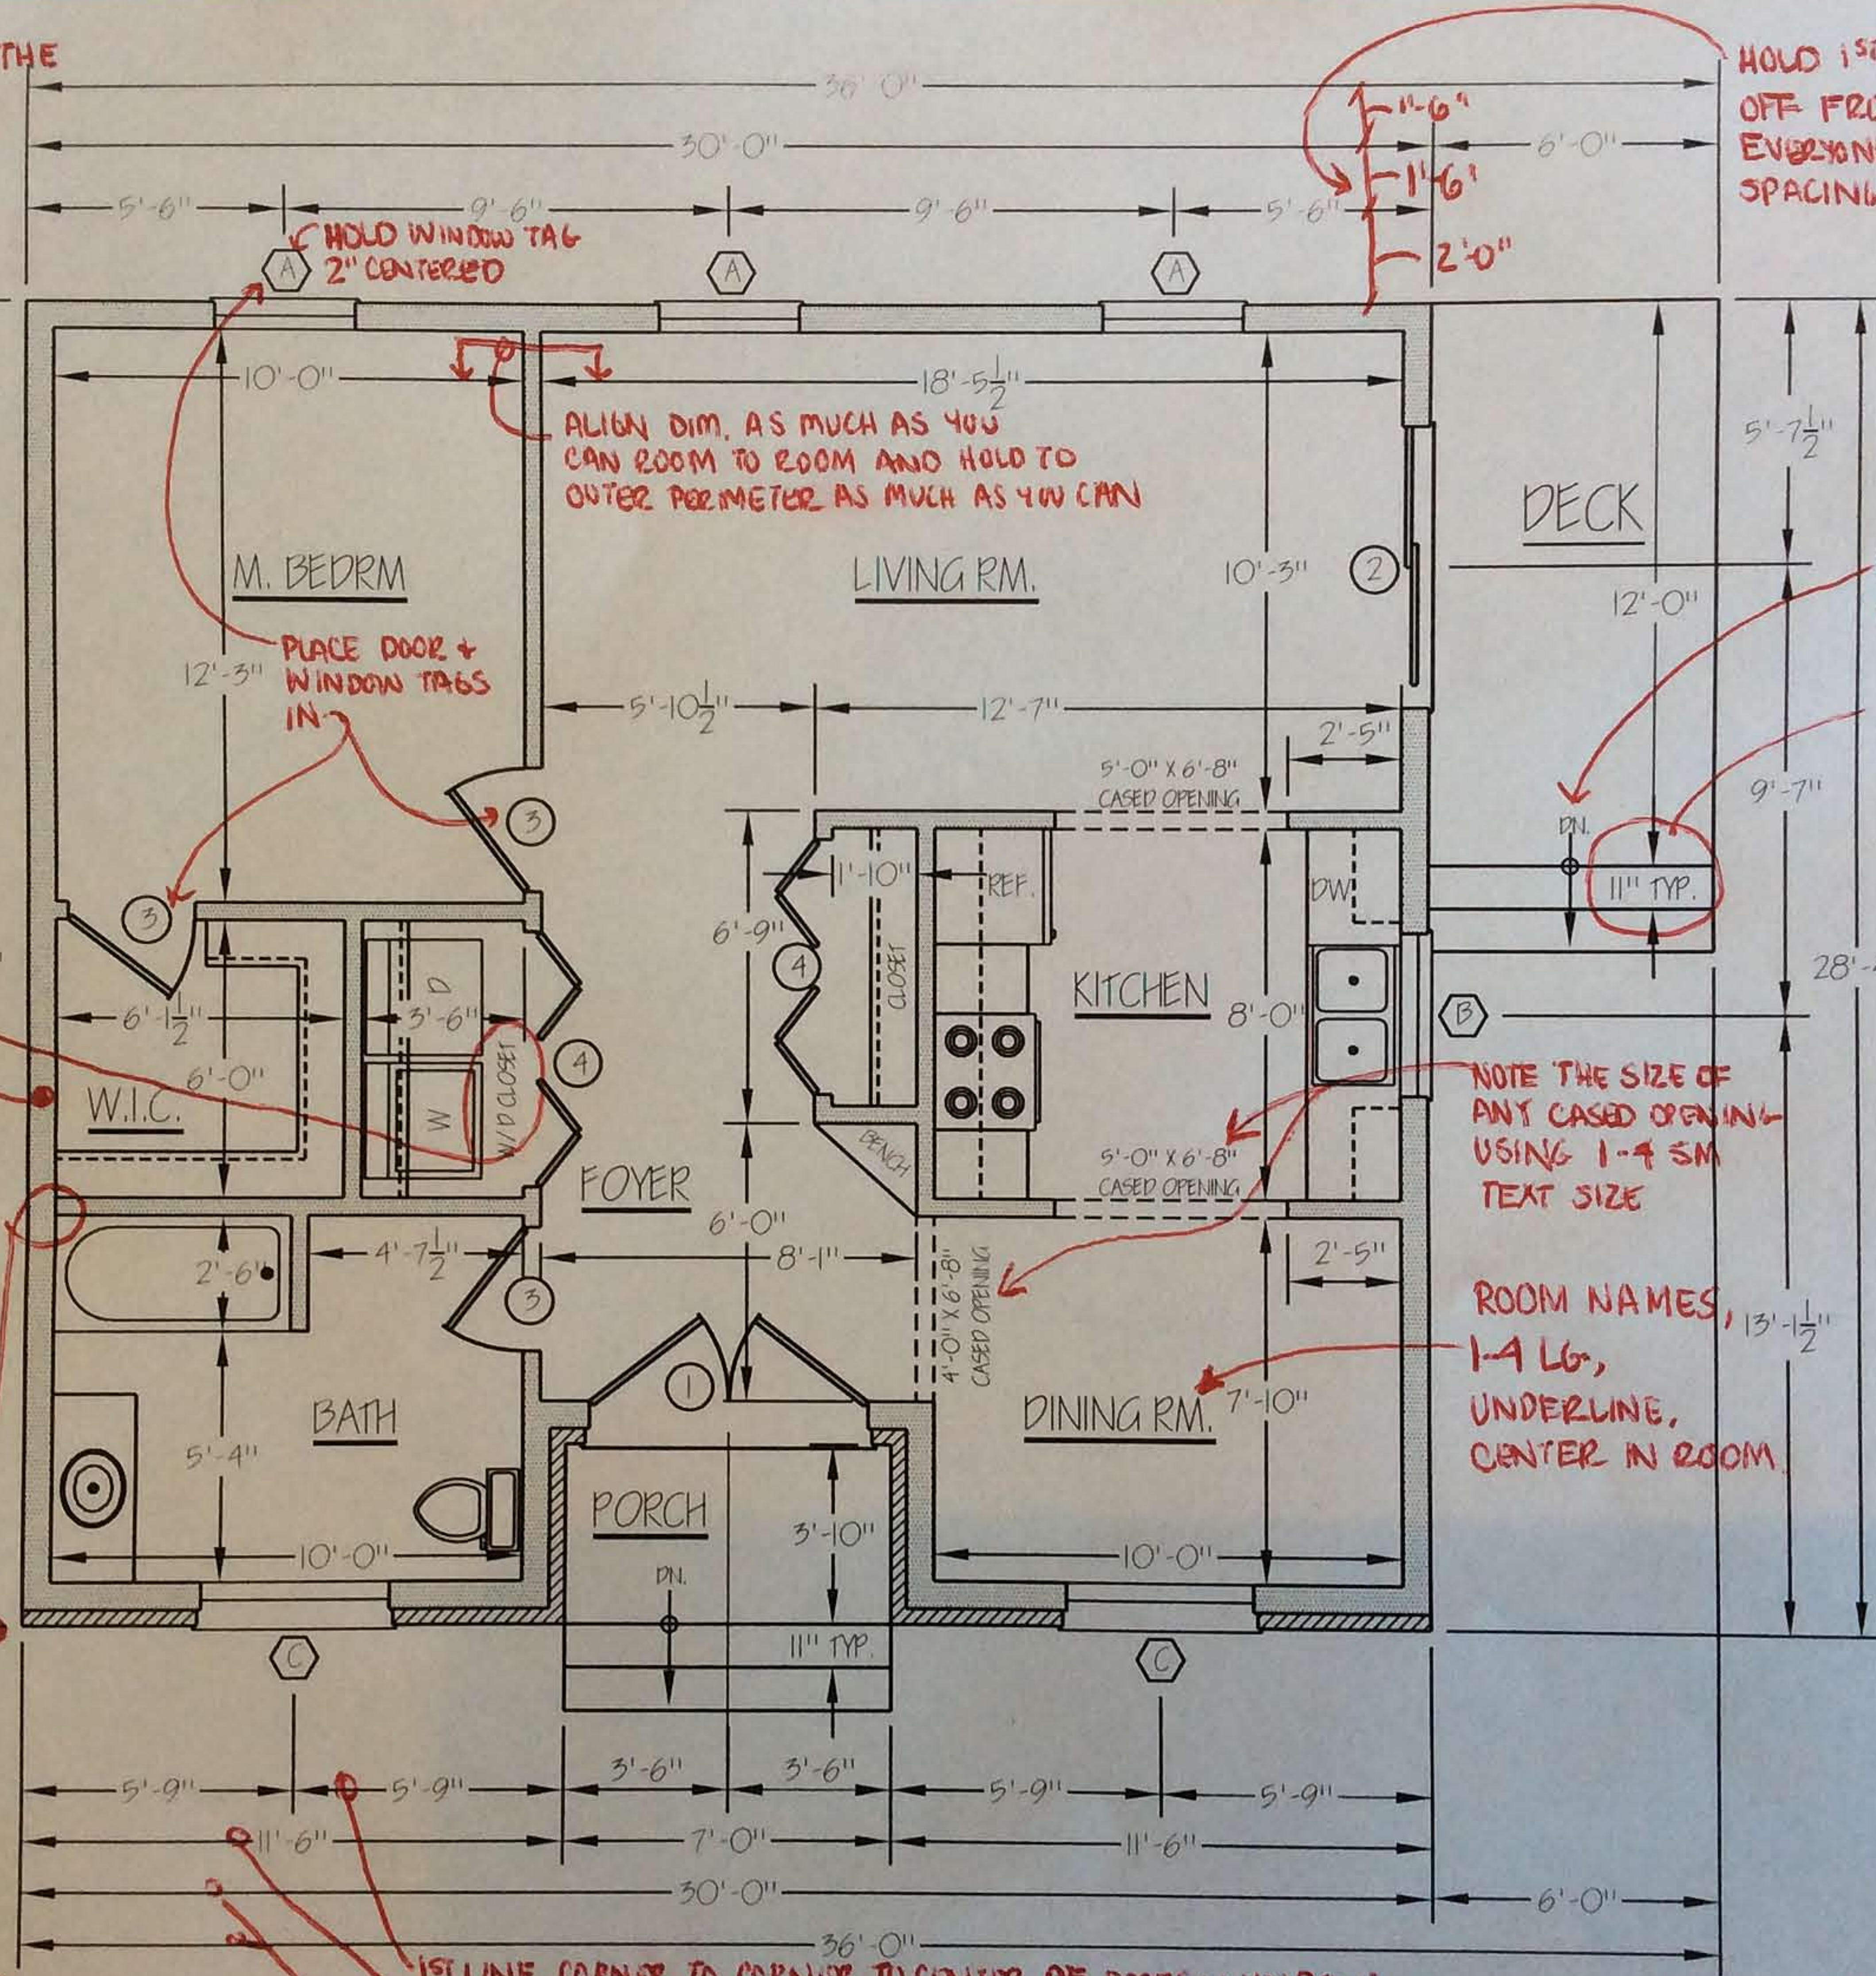

ALIGN DIM. AS MUCH AS YOU CAN ROOM TO ROOM AND HOLD TO OUTER PERIMETER AS MUCH AS YOU CAN

PLACE DOOR + WINDOW TAGS IN

DECK

SHOW DN. ARROW @ STAIRS.

DIM. (1) STEP AND NOTE AS TYP.

NOTE THE SIZE OF ANY CASIED OPENING - USING 1-4 SM TEXT SIZE

ROOM NAMES, 1-4 Lb, UNDERLINE, CENTER IN ROOM.

1ST LINE, CORNER TO CORNER TO CENTER OF DOORS + WINDOWS
2ND LINE, WALL "CHUNKS"
3RD (4TH) LINE OVERALL